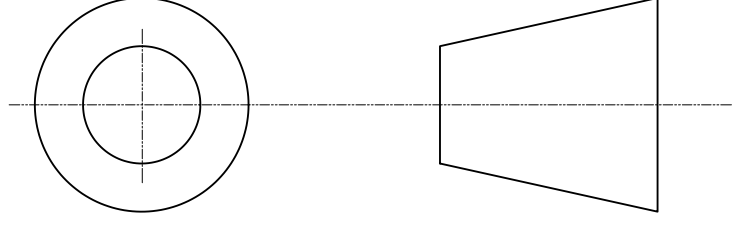


TANK G1 FRONT VIEW LAYOUT

Designed	SAMUEL OKUKU	
Drawn		
Checked		
Approved		
Client Approval		
Date		

DIMENSIONS	Millimeter
PROJECT NO	
	
DATE	

NOZZLE CONNECTIONS

POSITION	Quant.	Norm	Type	Size	Rating	Facing	Service
POSITION	Quant.	Norm	Type	Dimension	Class	Face	Service
A	2	ANSI	W.N.	NPS 20"	NON STANDARD	GF	MANHOLE
B	1	ANSI	W.N.	DN 22mm	NON STANDARD	GF	PRESSURE GAUGE
C	1	ANSI	W.N.	NPS 1"	150#	GF	BLIND FLANGED
D	2	ANSI	W.N.	NPS 3"	300#	GF	PRESSURE RELIEVE VALVE
E(s)	2	ANSI	W.N.	NPS 6"	NON STANDARD	GF	E ₁ - VAPOR LINE E ₂ - THERMO PROBE
F	1	ANSI	W.N.	NPS 6"	NON STANDARD	GF	LIQUID IN
G	1	ANSI	W.N.	NPS 5"	NON STANDARD	GF	RADAR GAUGE
H	4	ANSI	-	-	-	-	LIFTING LUG
I	1	ANSI	W.N.	NPS 2"	NON STANDARD	GF	INDEPENDENT HIGH HIGH LEVEL ALARM
J	1	ANSI	W.N.	NPS 1½"	NON STANDARD	GF	BLIND FLANGED
K	2	ANSI	-	-	-	-	TANK SADDLE AND RPAD
L	1	ANSI	W.N.	NPS 6"	NON STANDARD	GF	LIQUID RETURN
M	1	ANSI	W.N.	NPS 6"	NON STANDARD	GF	LIQUID OUT
N	1	ANSI	W.N.	NPS 1"	NON STANDARD	GF	WATER DRAIN
O	1	ANSI	W.N.	NPS 1½"	NON STANDARD	GF	BLIND FLANGED

CONSULTANT	CLIENT
Consultant 's Logo and Address	Client 's Logo and Address
TITLE	SITE
AS BUILT TANK G1 DRAWING	
EQUIPMENT	LPG TANK G1
SCALE 1:1	LAYOUT A1 841/594